
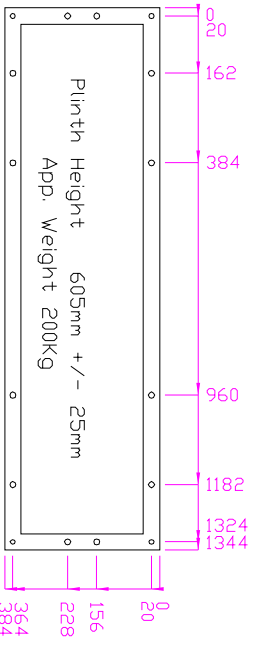


MODUL 1 2 3 4 5 6 7 8 9 10 11 12

CM7x10x2

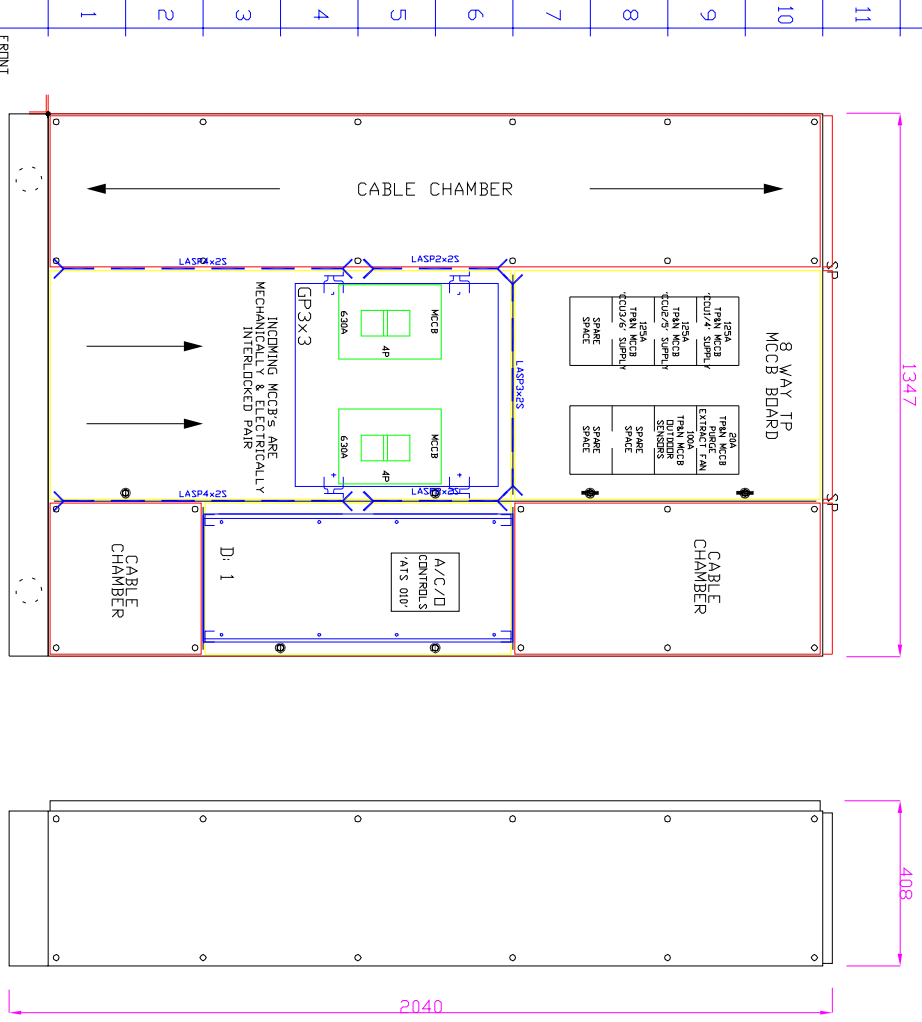

CCU PANEL PLINTH DIMENSIONS

K4400 C/D
BT TELEPHONE HOUSE
CCU ACD PANEL
ISSUE 03
AS BUILT AT KANE ENGINEERING

Ref. No:	K4400 C/D	Colour:	RAL 7035	Standard:	IEC 60439-1	Main busbar:	630A	Cable entry:	BT TOP	Rev:	02	Page No:	1	Width:	1347
Originator:	JP	IP:	43	Voltage:	415	Cable exit:	BT BOTTOM	Check:		Next page:	2	Height:	2040	Depth:	408
Date:		Form:	2 TYPE 2	Poles:	3 P+N	Scale:	NTS	DWG No:	K4400 C/D	Depth:	408				
Drawing No:	K4400 C/D	Access:	FRONT	Earthing System:		Dropers:	BT TELEPHONE HOUSE	Project:		DWG Rev:	02				



KANE ENGINEERING LIMITED
GLENFORD ROAD, NEWTOWNARDS, CO. DOW, NORTHERN IRELAND BT23 4AU
Tel: 028 9181 4465
Fax: 028 9181 8900
www.LowVoltageSwitchgear.com